


OUTDOORS

1ST FLOOR

MAIN DISTRIBUTION BOARD "MDB" 480/277 WYE 2500 AMP BUSS

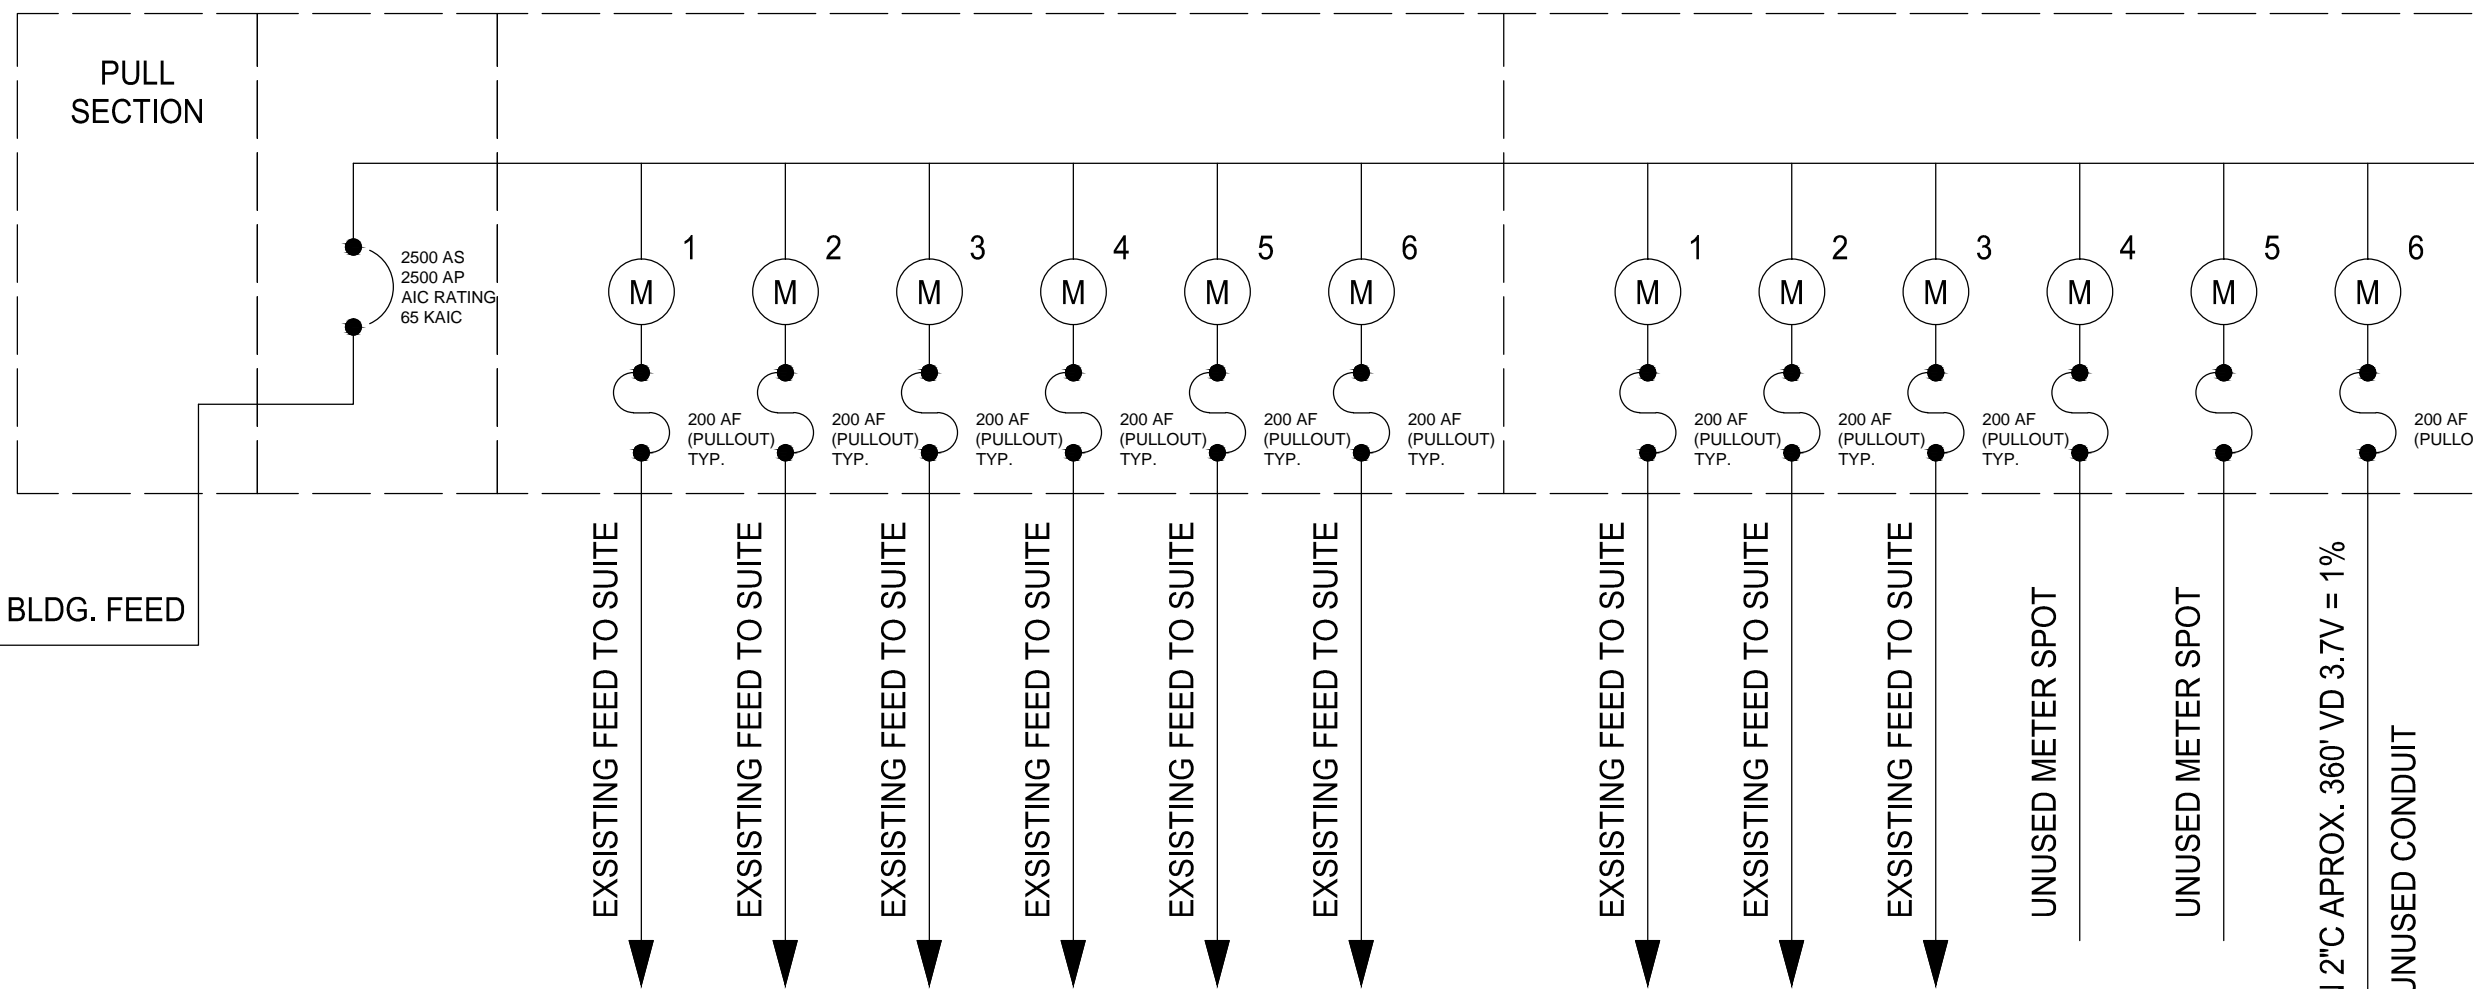

EXISTING SCE UNDERGROUND FEED


EXISTING UNDERGROUND BLDG. FEED

EXISTING J-BOX ON 2ND FLOOR

2ND FLOOR

NEW 8X8X24 WIREWAY MOUNTED ON EXISTING 2" C

3RD FLOOR

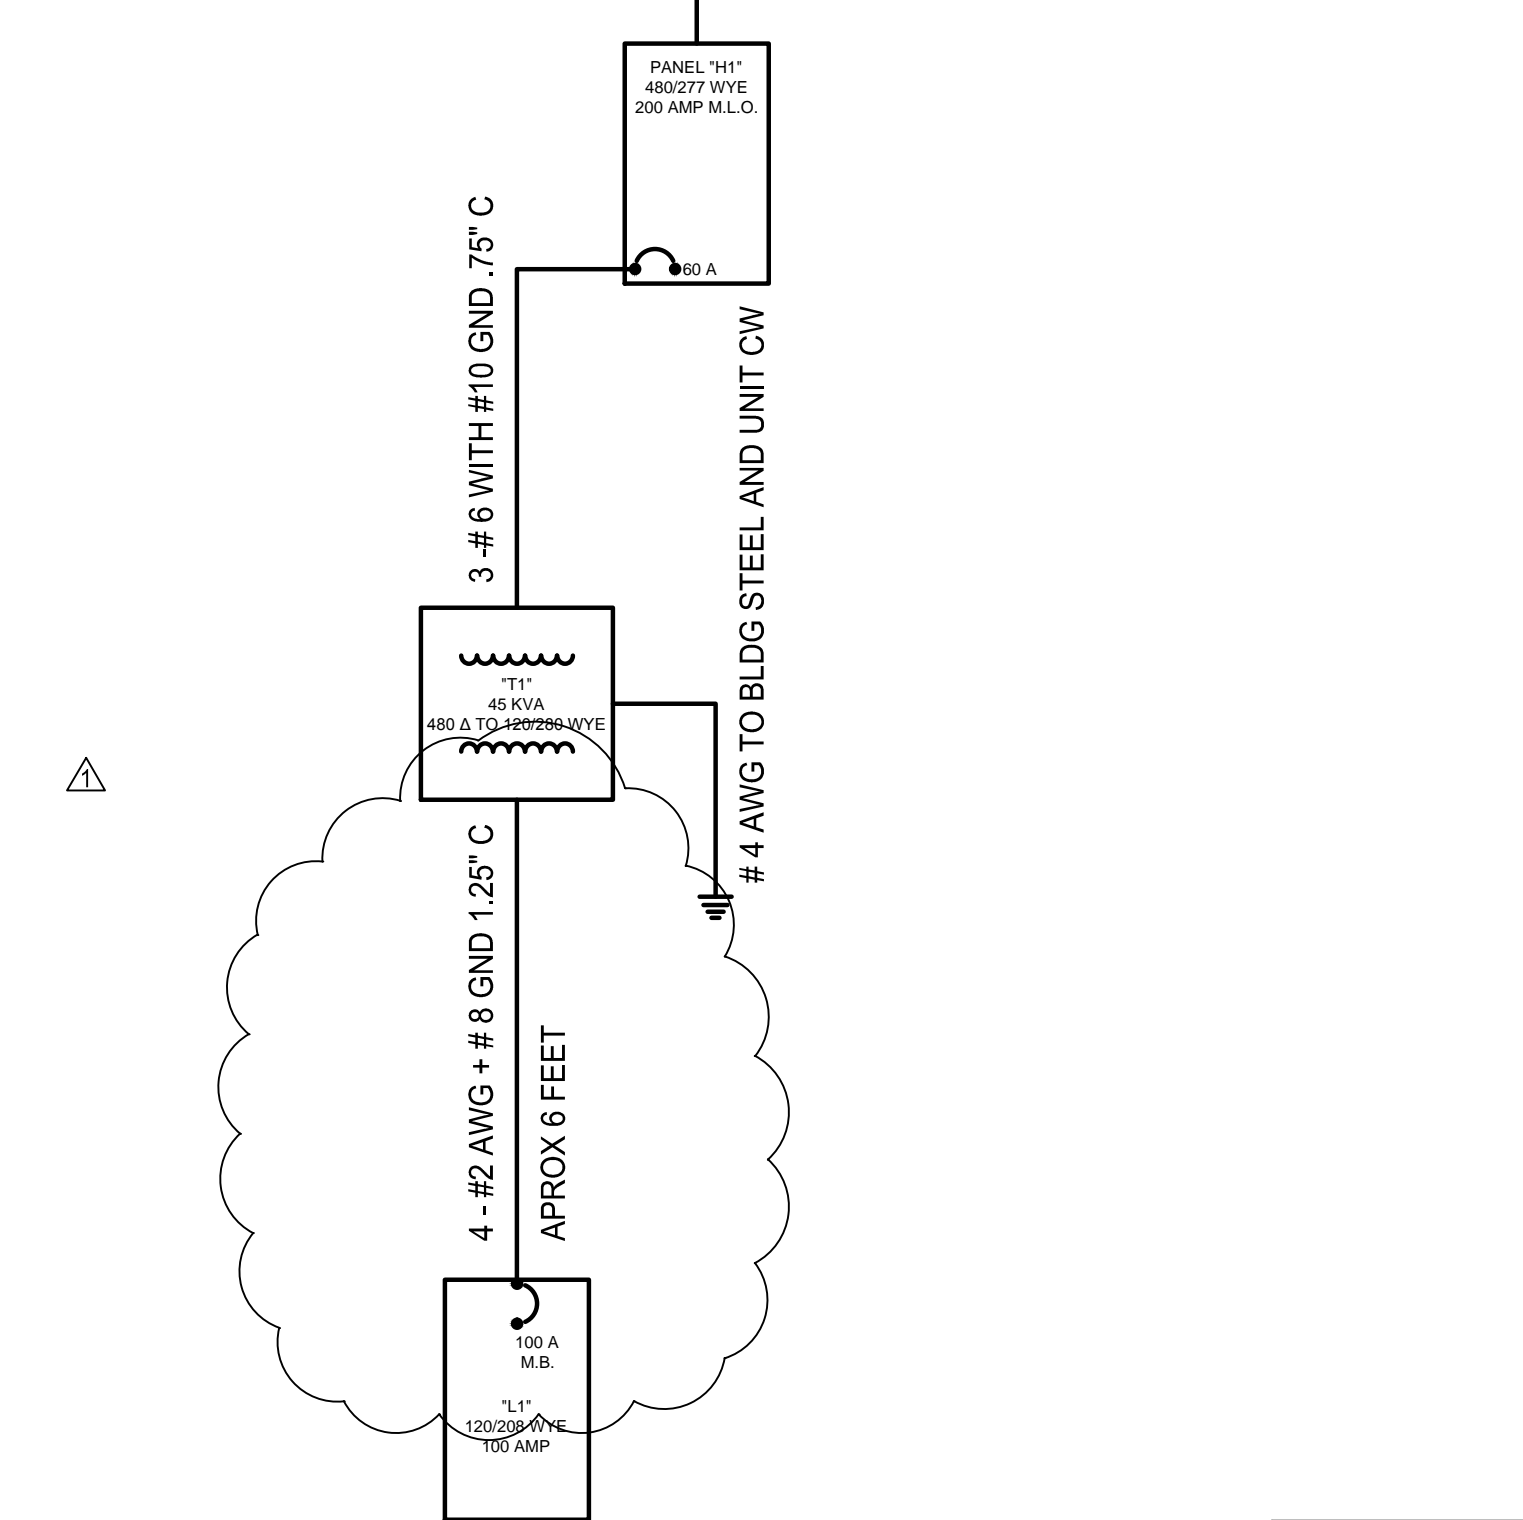

DESIGN/BUILD NOTES:

1. THESE DRAWINGS AND SPECIFICATIONS ARE THE SOLE PROPERTY OF AND COPYRIGHT BY PROFESSIONAL ELECTRICAL SERVICES, INC. THESE PLANS SHALL NOT BE USED, IN WHOLE OR IN PART BY ANY ENTITY OTHER THAN PROFESSIONAL ELECTRICAL SERVICES, INC. THESE PLANS REPRESENT A SCHEMATIC DESIGN/BUILD LAYOUT OF THE ELECTRICAL SYSTEMS; THESE PLANS MAY NOT INDICATE ALL MATERIALS THAT WILL BE REQUIRED TO PROVIDE A COMPLETE AND OPERATING ELECTRICAL SYSTEMS.

2. THESE PLANS WERE PREPARED UNDER THE EXEMPTION TO DIVISION 3 OF THE CALIFORNIA BUSINESS AND PROFESSIONS CODE BY SECTION 5537.2, AS THE LICENSED CONTRACTOR RESPONSIBLE FOR THE PREPARATION OF THESE DRAWINGS, ONLY PROFESSIONAL ELECTRICAL SERVICES, INC. MAY UTILIZE THEM.

PROFESSIONAL ELECTRICAL SERVICES

2028 VERDUGO BLVD. #1034  
MONTROSE, CA 91020  
TEL: (818) 834-8512

OFFICE TENANT IMPROVEMENT  
VALENCIA, CA

REVISIONS:  
A PLAN CHECK CORRECTION  
15 JUNE 2012

DRAWING TITLE:  
SINGLE LINE  
DRAWING

DRAWN BY:  
D. URSINI  
SCALE:  
N.T.S

DRAWN DATE:  
15 MAY 2012

SHEET NO.

E-2